


DETAIL A  
SCALE: 1" = 20'

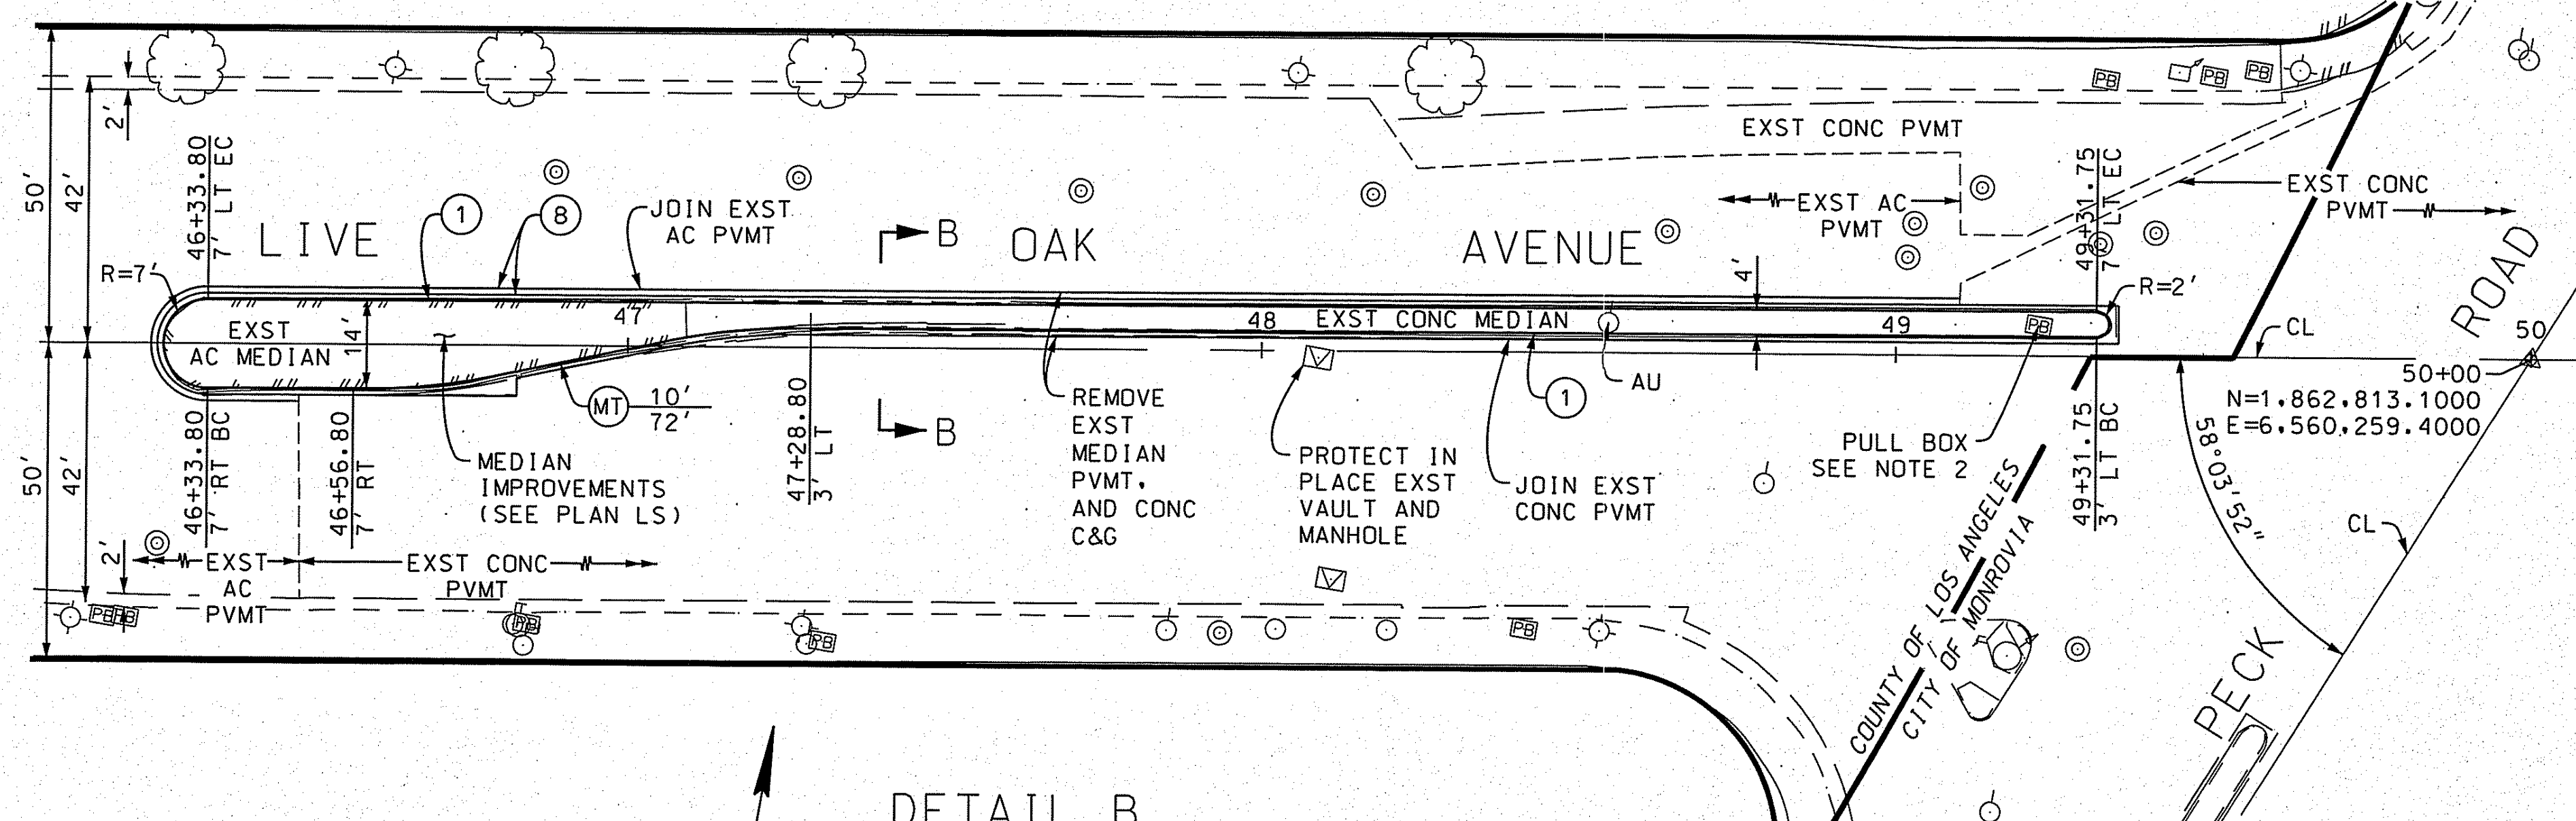

DETAIL B  
SCALE: 1" = 20'

### NON-STANDARD ABBREVIATIONS

AC	ASPHALT CONCRETE	MTL	MATERIAL
BC	BEGINNING OF CURVE	PVMT	PAVEMENT
C&G	CURB AND GUTTER	PWFB	PUBLIC WORKS FIELD BOOK
CL	CENTER LINE	RT	RIGHT
CONC	CONCRETE	STR GR	STRAIGHT GRADE
EC	END OF CURVE	TC	TOP OF CURB
EXST	EXISTING	VAR	VARIABLE
LT	LEFT		

### CONSTRUCTION SYMBOLS


- (NO) INDICATES WORK PER CONSTRUCTION LEGEND
- 2" P4 ABOVE LINE: INDICATES THE TYPE OF STANDARD; THICKNESS OF SURFACE MATERIAL IN INCHES; STD PLAN VARIABLES; OR CURB RAMP CASE
- 5" CMB BELOW LINE: REFERENCE TO DETAIL; THICKNESS OF BASE MATERIAL IN INCHES; OR TREE WELL CASE
- MT  $\frac{W}{L}$  MEDIAN TAPER PER STD PLAN 140-3
- MF  $\frac{W}{L}$  MEDIAN FLARE PER STD PLAN 141-2
- ← AU UTILITY TO BE ADJUSTED VERTICALLY BY OWNER

### CONSTRUCTION LEGEND


- 1 PORTLAND CEMENT CONCRETE CURB AND GUTTER
- 2 PORTLAND CEMENT CONCRETE CURB
- 8 ASPHALT CONCRETE PAVEMENT

### STANDARD PLANS

SPPWC, 2012 EDITION
112-2 CURB AND SIDEWALK JOINTS
120-2 CURB AND GUTTER - BARRIER
140-3 MEDIAN TAPER
141-2 MEDIAN FLARE

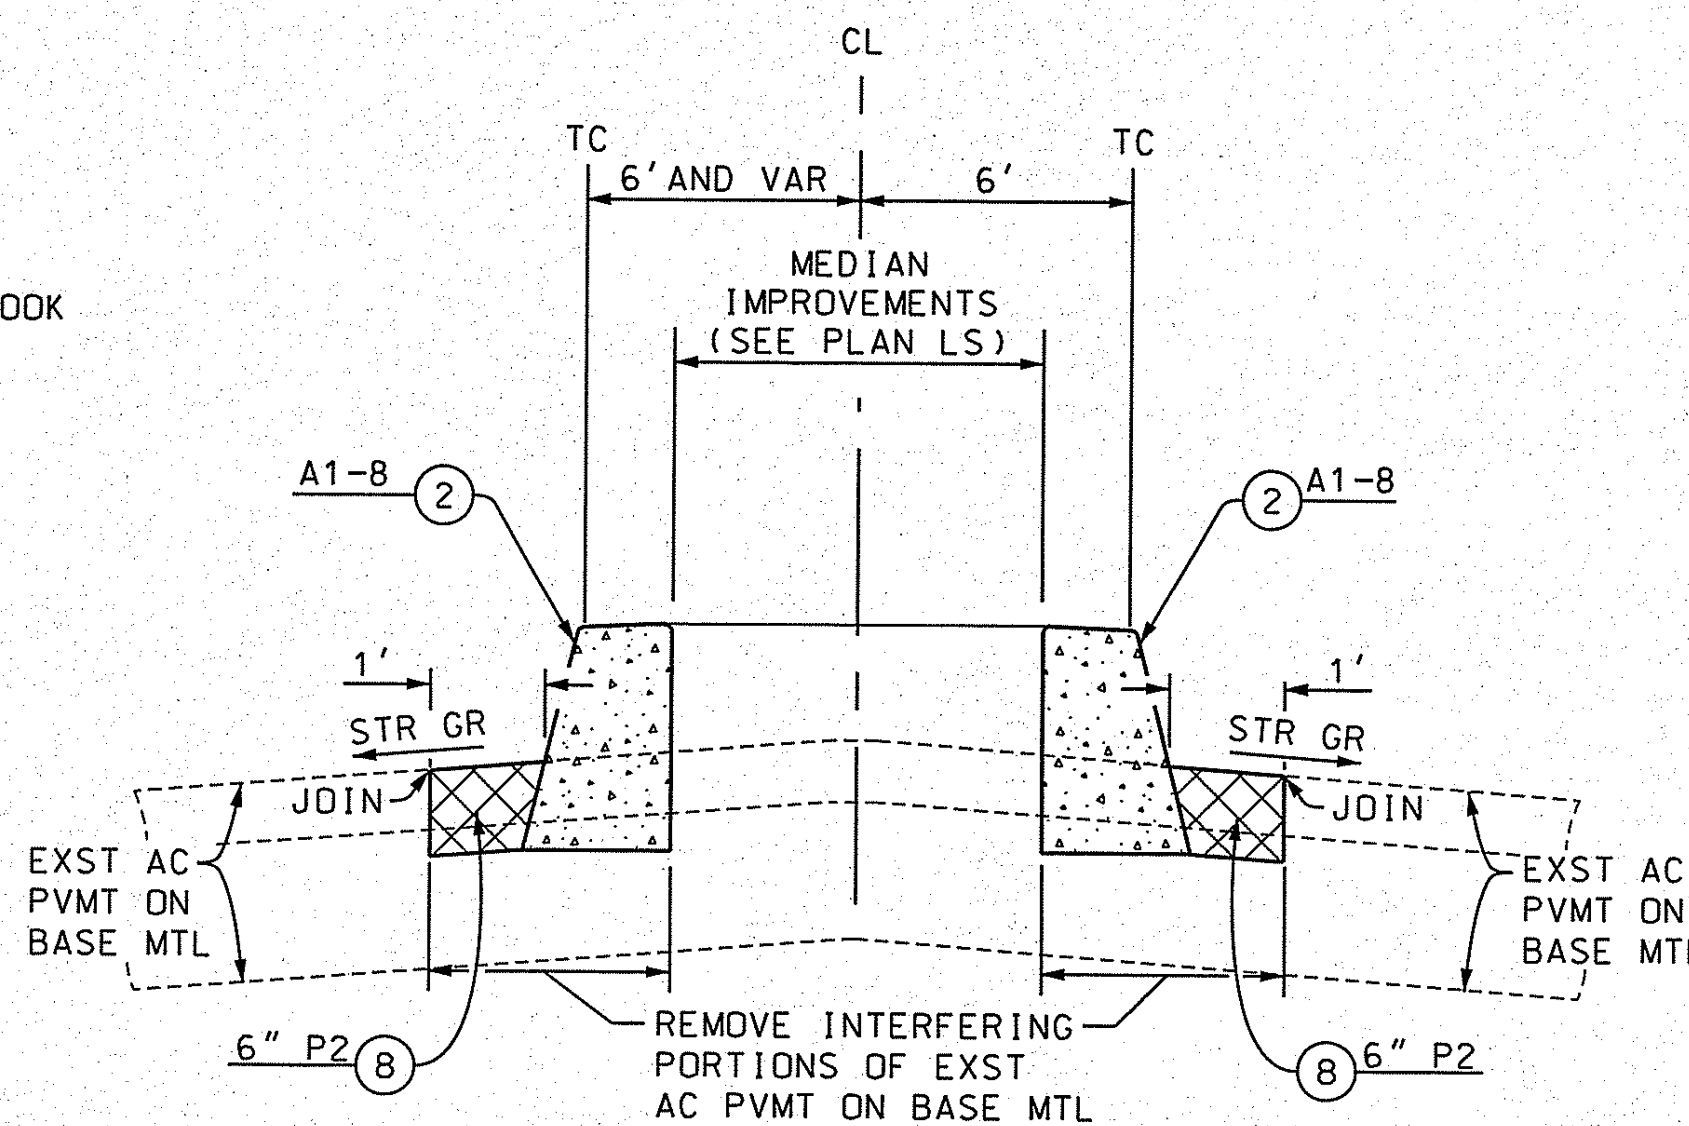

SECTION A-A  
NO SCALE

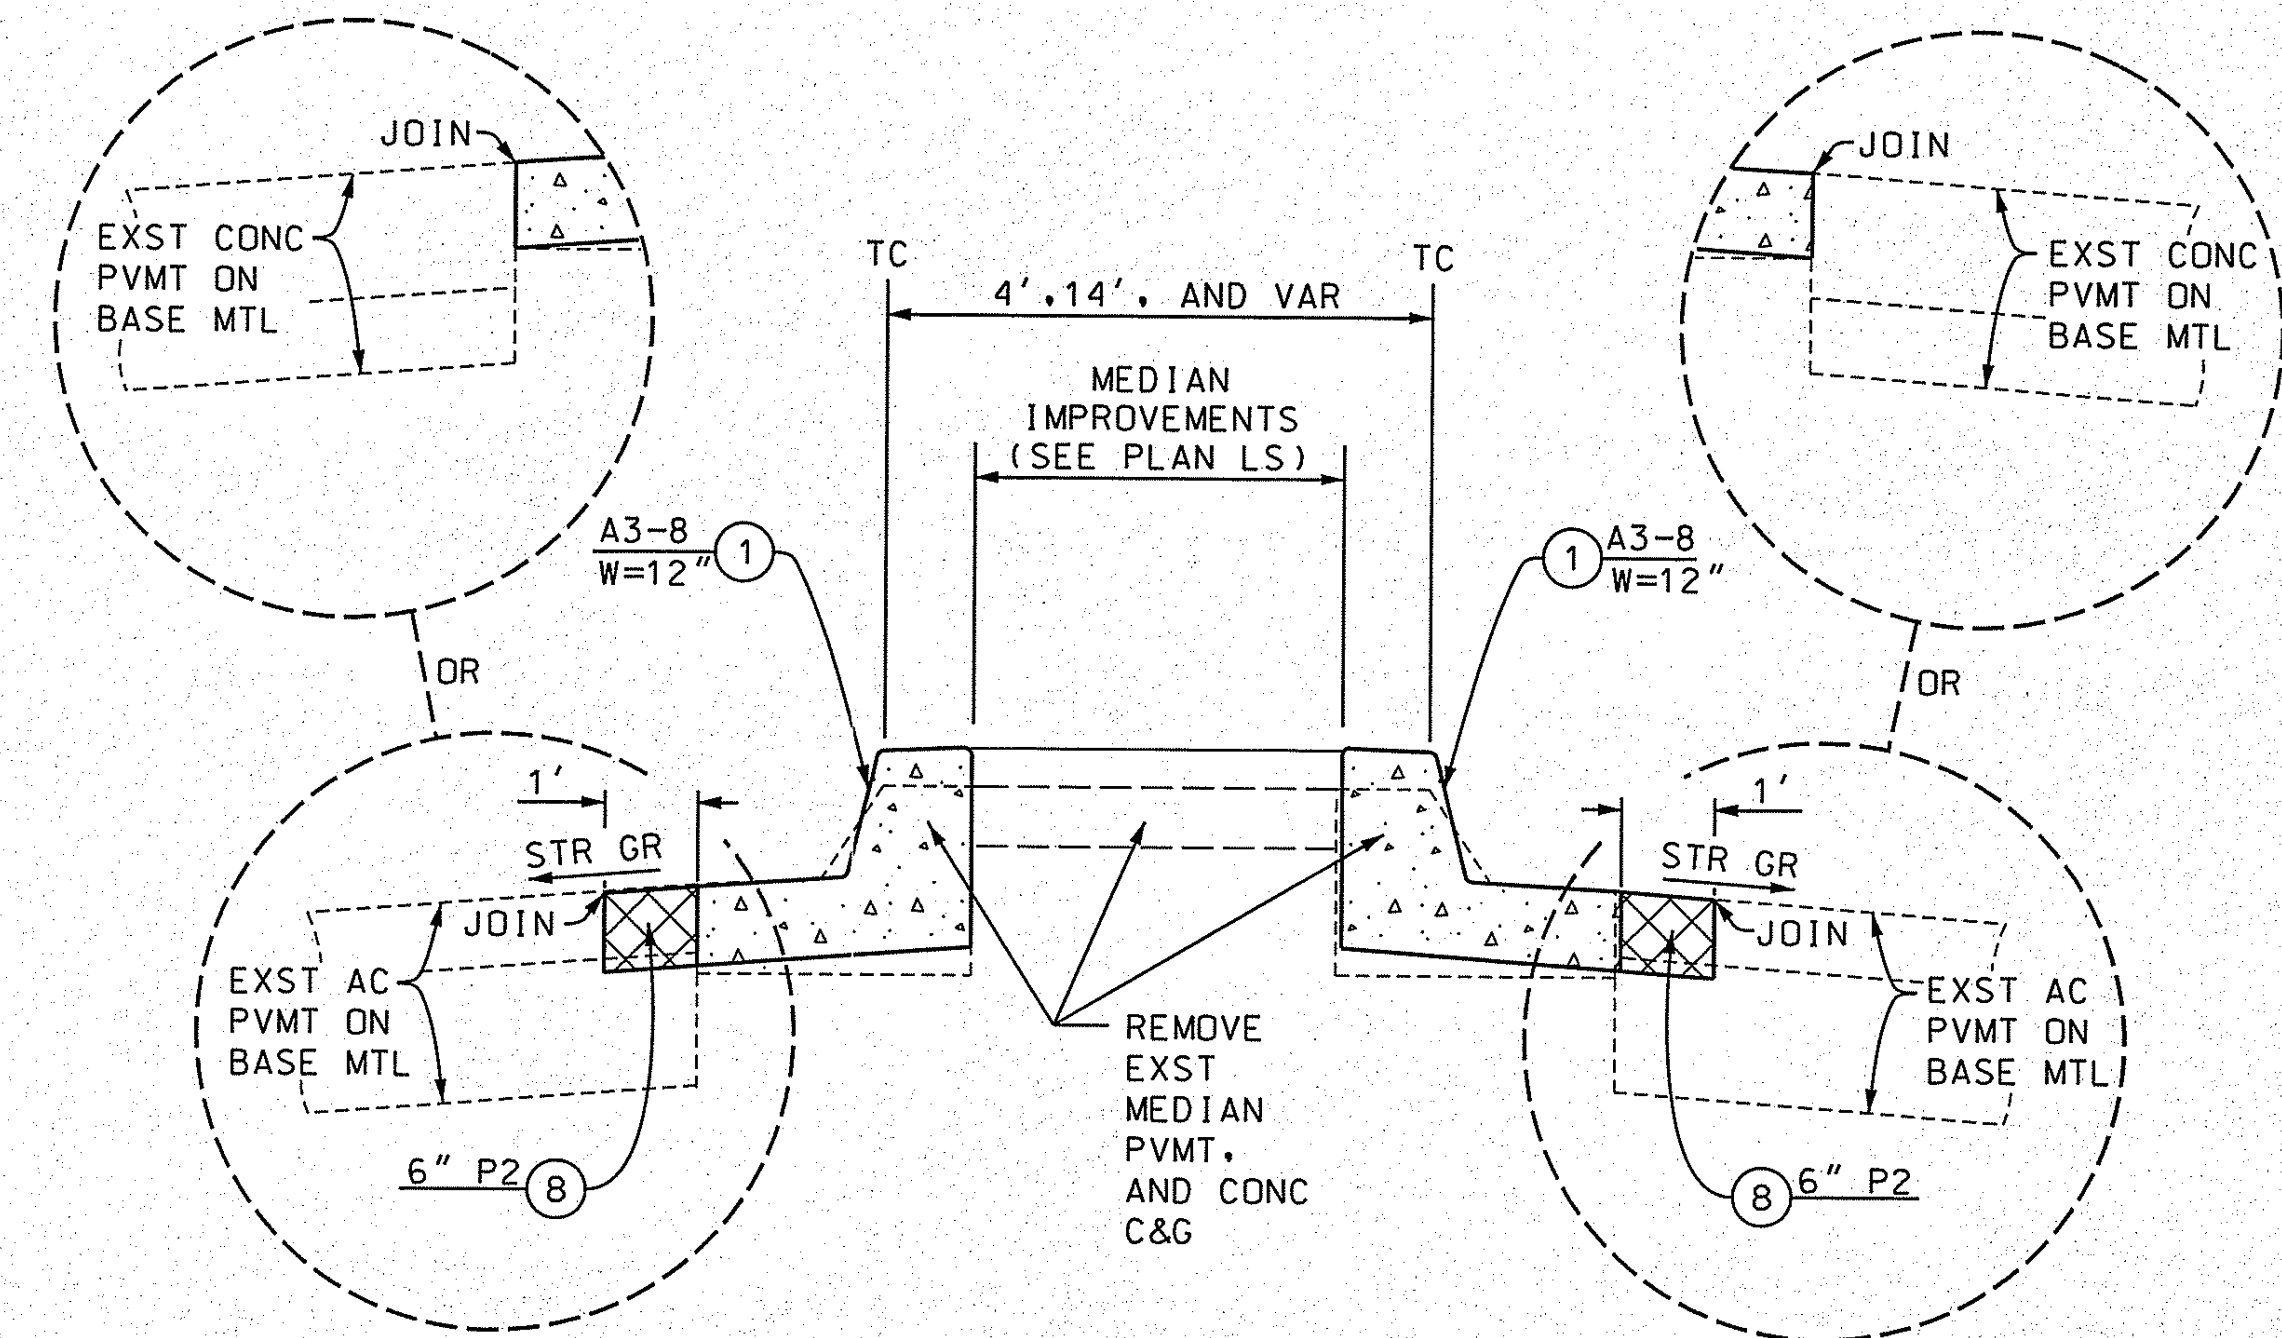

SECTION B-B  
NO SCALE

### CONSTRUCTION NOTES

- CHECKED BOXES ARE FOR ITEMS APPLICABLE TO THIS PROJECT
- 1. STANDARD PLANS REFERENCED ARE PER THE STANDARD PLANS FOR PUBLIC WORKS CONSTRUCTION (SPPWC) UNLESS OTHERWISE NOTED.
- 2. REPLACE AND ADJUST TRAFFIC SIGNAL PULL BOX AFFECTED BY MEDIAN CONSTRUCTION. PAYMENT WILL BE MADE AT THE CONTRACT UNIT PRICE FOR NO. 6 PULL BOX INCL PCC COVER.

### REFERENCES

- 1. PWFB 1528 PAGES 1943-1948, 1986-1989

### AC PAVEMENT CLASS AND GRADE LEGEND

P1 C2-PG 64-10	P3 B-PG 64-10
B-PG 64-10	P4 D2-PG 64-10
P2 C2-PG 64-10	

### AS-BUILT DRAWING

PH084574

COUNTY OF LOS ANGELES DEPARTMENT OF PUBLIC WORKS

MONROVIA-ARCADIA-DUARTE  
COMMUNITY MONUMENT SIGNS

PLAN  
PROJECT ID NO. RDC0015857

PCA X250000678 DWG

SHEET 1 OF 1

PLAN RD

REVIEWED BY: *[Signature]* DATE: 6/24/15

CADD PROJECT FILE NAME: RDC0015763-PLAN-RD.DGN

CHECKER: D. RADLE

DESIGNER: R. DAVIS

DRAFTER: R. DAVIS

APPROVED BY: *[Signature]* DATE: 6/24/15

DATE	MK	DESCRIPTION

PROJECT ENGINEER: *[Signature]* DATE: 6/24/15